


**Tree Location and Protection Plan 1.10.2020**

All dimensions are to be checked on site. Do not scale from this drawing  
Proposals are subject to site survey and statutory approvals

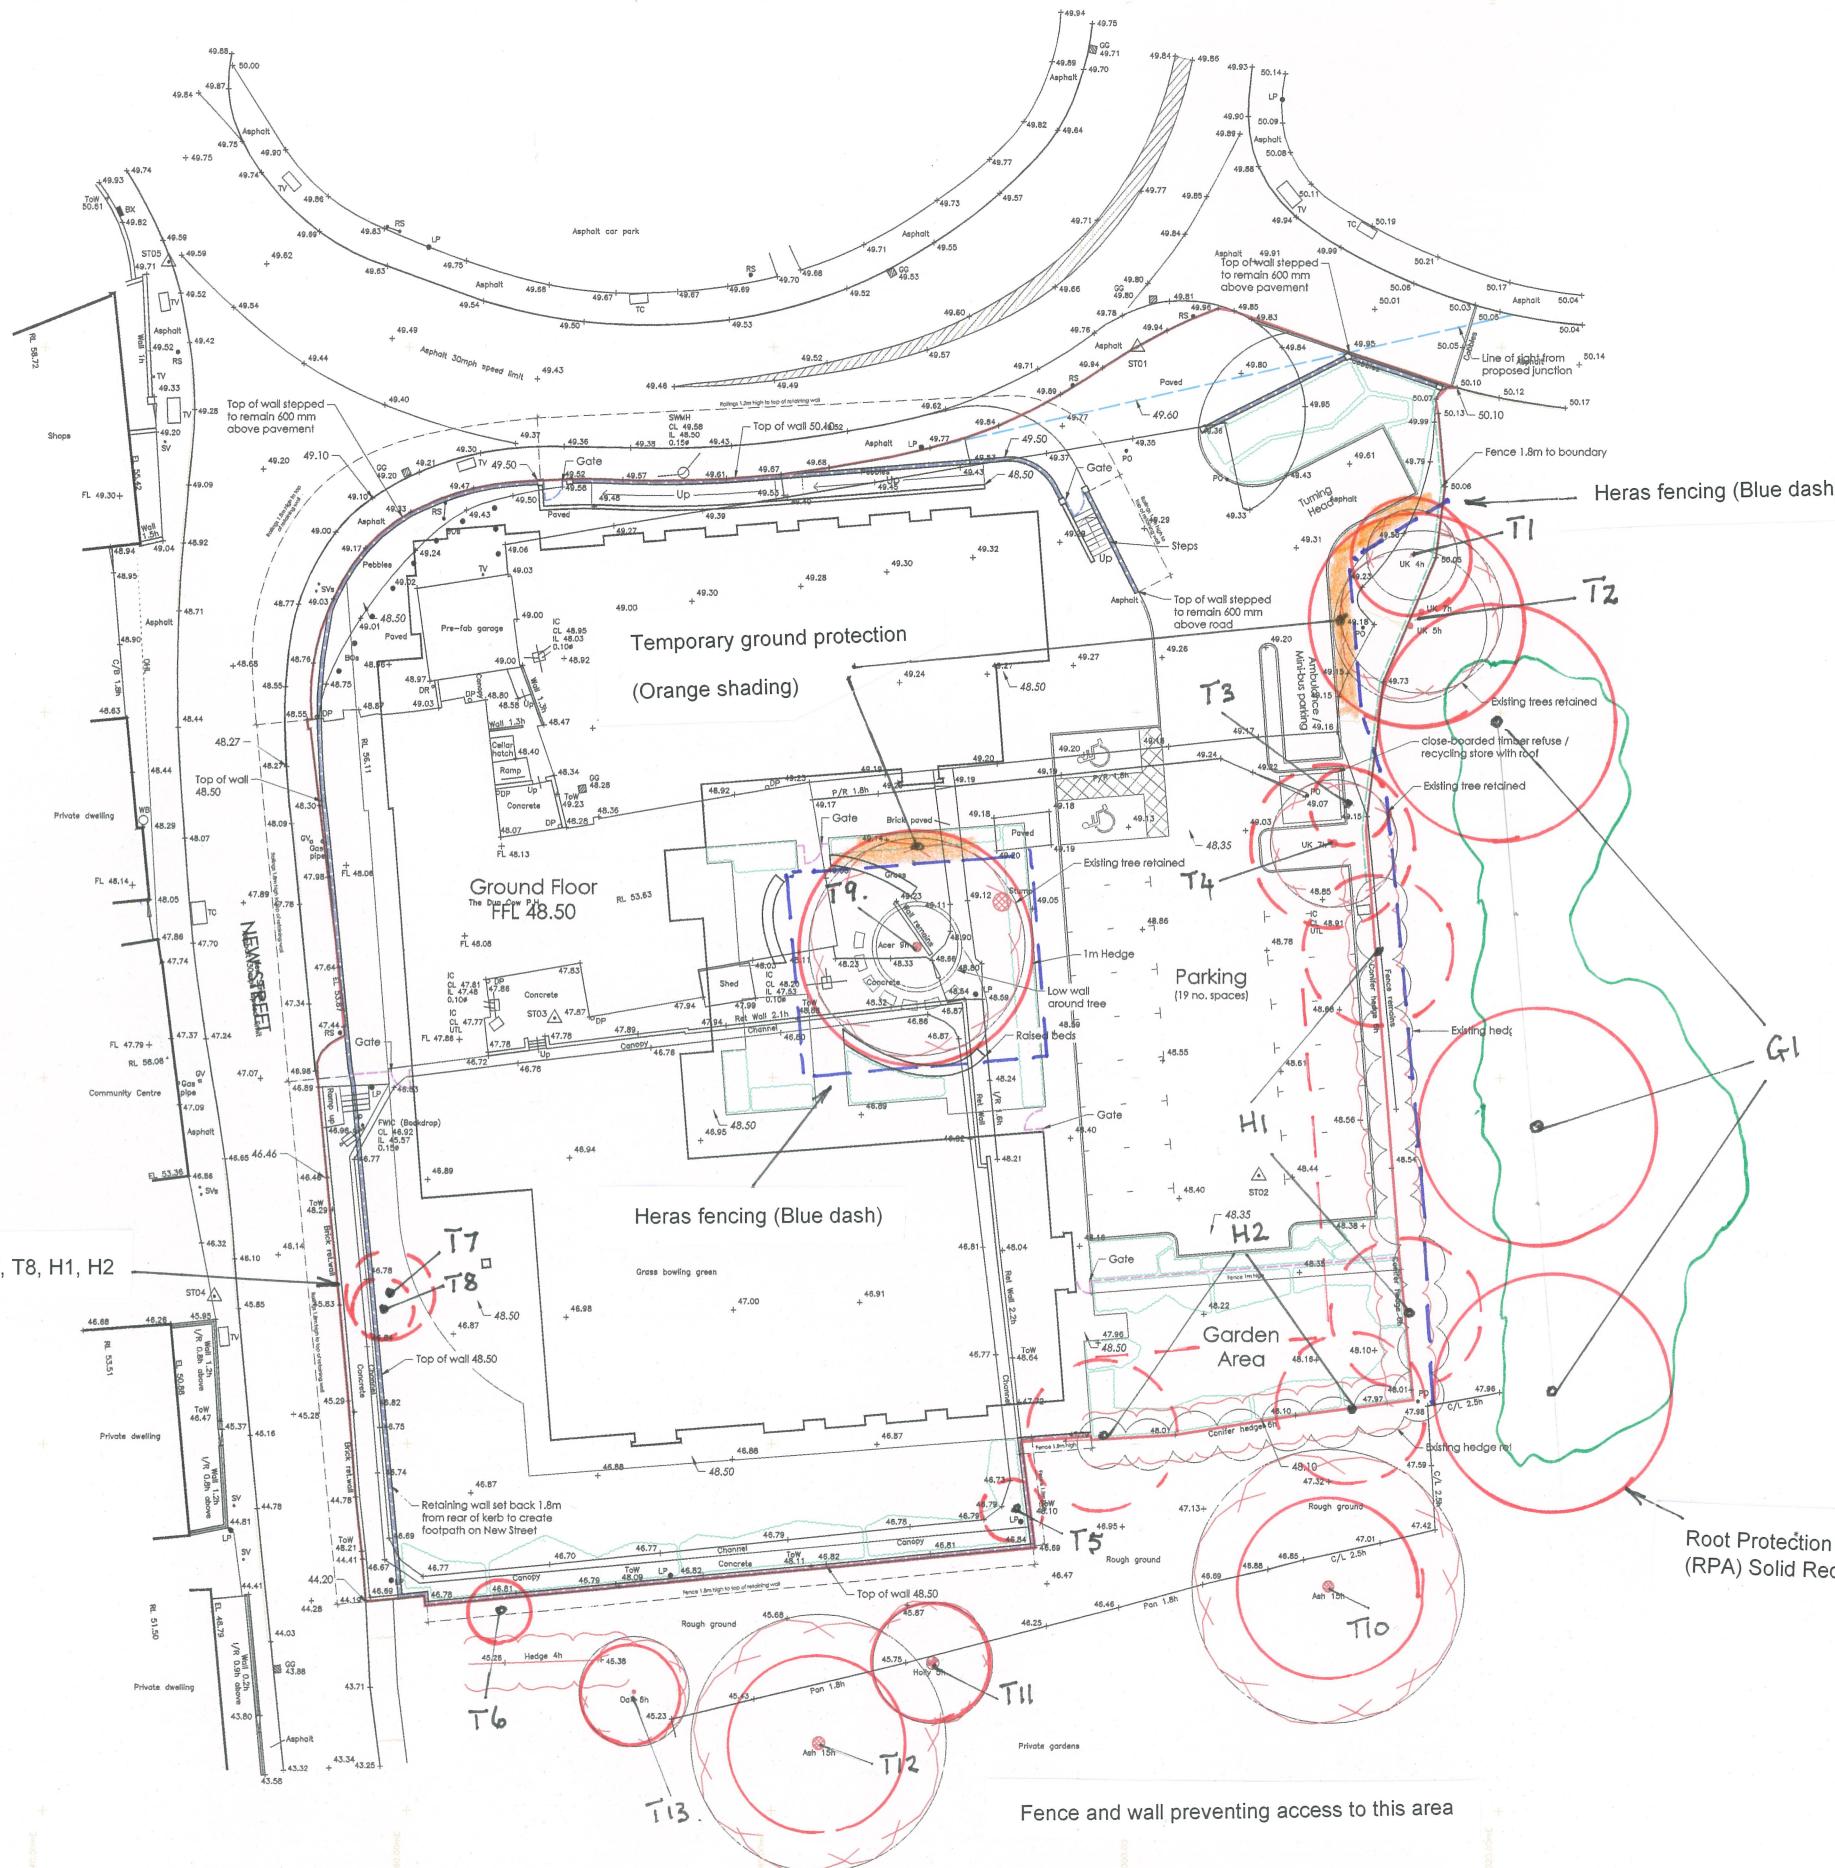

**ABBREVIATIONS**

AV	Air Valve	PH	Fire Hydrant	SP	Sign Post
AVH	Arch Head Height	FL	Floor Level	SP	Arch Spring Point Height
BB	Bellia Beacon	FP	Flag Pole	SV	Stop Valve
BS	Box Hole	GD	Gully Drain	SV	Stop Valve
BL	Bar Level	GV	Gas Valve	Tac	Tackles Paving
BU	Bulb	HH	Head Height	TC	Telcom Cover
BUP	Brace Post	IC	Inception Cover	TH	Trifid Pole
BS	Bus Stop	L	Invert Level	THL	Threshold Level
Bush	Bush	KC	Kash Cabinet	TL	Trunk Light
BK	Box (Utilities)	LP	Lamp Post	TOW	Top of Wall
CL	Cable Level	MH	Manhole	TP	Telephone Pole
CH	Chimney	MP	Master Post	TV	Cable TV Cover
CL	Cover Level	NB	Name Board	UB	Universal Beam
COL	Column	PHW	Parish Wall	UD	Unkown Cover
DC	Drainage Channel	PM	Post Meter	UK	Unkown Tree
DH	Door Head Height	PO	Post	UTL	Unkown To L/R
DP	Down Pipe	PS	Post Box	USB	Under Side Beam
DR	Drain	RE	Roofing Eye	VP	Void Pipe
EL	Elve Level	RL	Ridge Level	WB	Waste Bin
EP	Electric Pole	RP	Roller Post	WH	Water Hose
ER	Earth Rod	RS	Road Sign	WL	Water Level
ET	EP-Transformer	RSD	Roller Shutter Door	WM	Water Meter
FB	Floor Board Direction	RBJ	Roller Board Joint	WO	Waste Out

**FEATURES**

FENCE: FENCE

WALL: WALL

HEDGE: HEDGE

OVERHEAD LINE: OVERHEAD LINE

MEASUREMENTS TO INTERNAL WALLS HAVE BEEN TAKEN TO THE WALL FINISHES AT APPROX 1m ABOVE FLOOR LEVEL AND ASSUMED TO BE VERTICAL.

**FENCE TYPES**

B/W SHABED WIRE: CL CHAIN LINK: IR: RR: CP: CR: P: RW: P: RW:

**SYMBOLS**

FLOOR TO CEILING HEIGHT: FLOOR TO FALSE CEILING HEIGHT: CONTROL STATION:

CILL HEIGHTS ARE MEASURED AS FLOOR TO CILL HEAD HEIGHTS ARE MEASURED FROM CILL TO TOP OF WINDOW

**SERVICES**

FOUL SEWERS: FIVE POSITIONS AND ALIGNMENTS ARE INDICATIVE ONLY.

STORM SEWERS:

**TREES**

TREES ARE DRAWN TO SCALE SHOWING THE AVERAGE CANOPY SPREAD. DESCRIPTIONS AND HEIGHTS SHOULD BE USED AS A GUIDE ONLY.

ALL BELOW GROUND DETAILS INCLUDING DRAINAGE, VOIDS AND SERVICES HAVE BEEN IDENTIFIED FROM ABOVE GROUND AND THEREFORE ALL DETAILS RELATIVE TO THESE FEATURES INCLUDING: EASES, DEPTH, DESCRIPTION ETC WILL BE APPROXIMATE ONLY. ANY CRITICAL DIMENSIONS AND CONNECTIONS SHOULD BE CHECKED AND VERIFIED PRIOR TO STARTING WORK.

SERVICES AND DETAIL MAY NOT HAVE BEEN SURVEYED IF OBSTRUCTED OR NOT REASONABLY VISIBLE AT THE TIME OF SURVEY.

THE CONTRACTOR MUST CHECK AND VERIFY ALL SITE AND BUILDING DIMENSIONS, LEVELS, UTILITIES AND DRAINAGE DETAILS AND CONNECTIONS PRIOR TO COMMENCING WORK.

ALL CRITICAL DIMENSIONS AND MEASUREMENTS SHOULD BE CHECKED AND VERIFIED WITH ANY ERRORS OR DISCREPANCIES NOTIFIED TO SURVEY SOLUTIONS IMMEDIATELY. THE ACCURACY OF THE DIGITAL DATA IS THE SAME AS THE PLOTTING SCALE IMPLIES. ALL DIMENSIONS ARE IN METRES UNLESS OTHERWISE STATED.

© LAND SURVEY SOLUTIONS LIMITED HOLD THE COPYRIGHT TO ALL THIS INFORMATION CONTAINED WITHIN THIS DOCUMENT AND THEIR WRITTEN CONSENT MUST BE OBTAINED BEFORE COPYING OR USING THE DATA OTHER THAN FOR THE PURPOSE IT WAS ORIGINALLY SUPPLIED.

G1: indicative location

Trees to be removed: T3, T4, T5, T7, T8, H1, H2

Root Protection Area (RPA) Solid Red line/circle

Fence and wall preventing access to this area

P1	First Issue	30.03.20
Rev	Description	Date



Keel Row 4 | The Watermark | Gateshead | NE11 9SZ  
E: info@iba-architects.com T: 0191 461 1411  
www.iba-architects.com

Project: NEW CARE HOME  
New Street  
Dowley, TF4 3JR

Title: TREE OVERLAY

Client: BONDCARE  
18 Lodge Road  
London  
NW4 4EP

Drawn: AM Scale: 1:200 ©A1  
Checked: NB Date: 30.03.20

**PRELIMINARY**

1494 (SK)09 P1  
THIS DRAWING IS COPYRIGHT

